




Rhif y Cais / Application Number : C15/0162/33/LL

Cynllun lleoliad ar gyfer adnabod y safle yn unig. Dim i raddfa.
Location Plan for identification purposes only. Not to scale.



A gyfrinbarth y map hon o Ddwyded ym Ddangosfa Survey y cyhoeddwyd ym 2006. Dim hysbysu i'r Gyhoeddwr ym 2006.
This map is reproduced from Ordnance Survey materials with the permission of Ordnance Survey on behalf of the Controller of Her Majesty's Stationery Office. © Crown copyright. Unauthorised reproduction infringes Crown copyright and may lead to prosecution and/or civil proceedings. Cynllun Gwynedd - 1 000 00 0001 - 2006

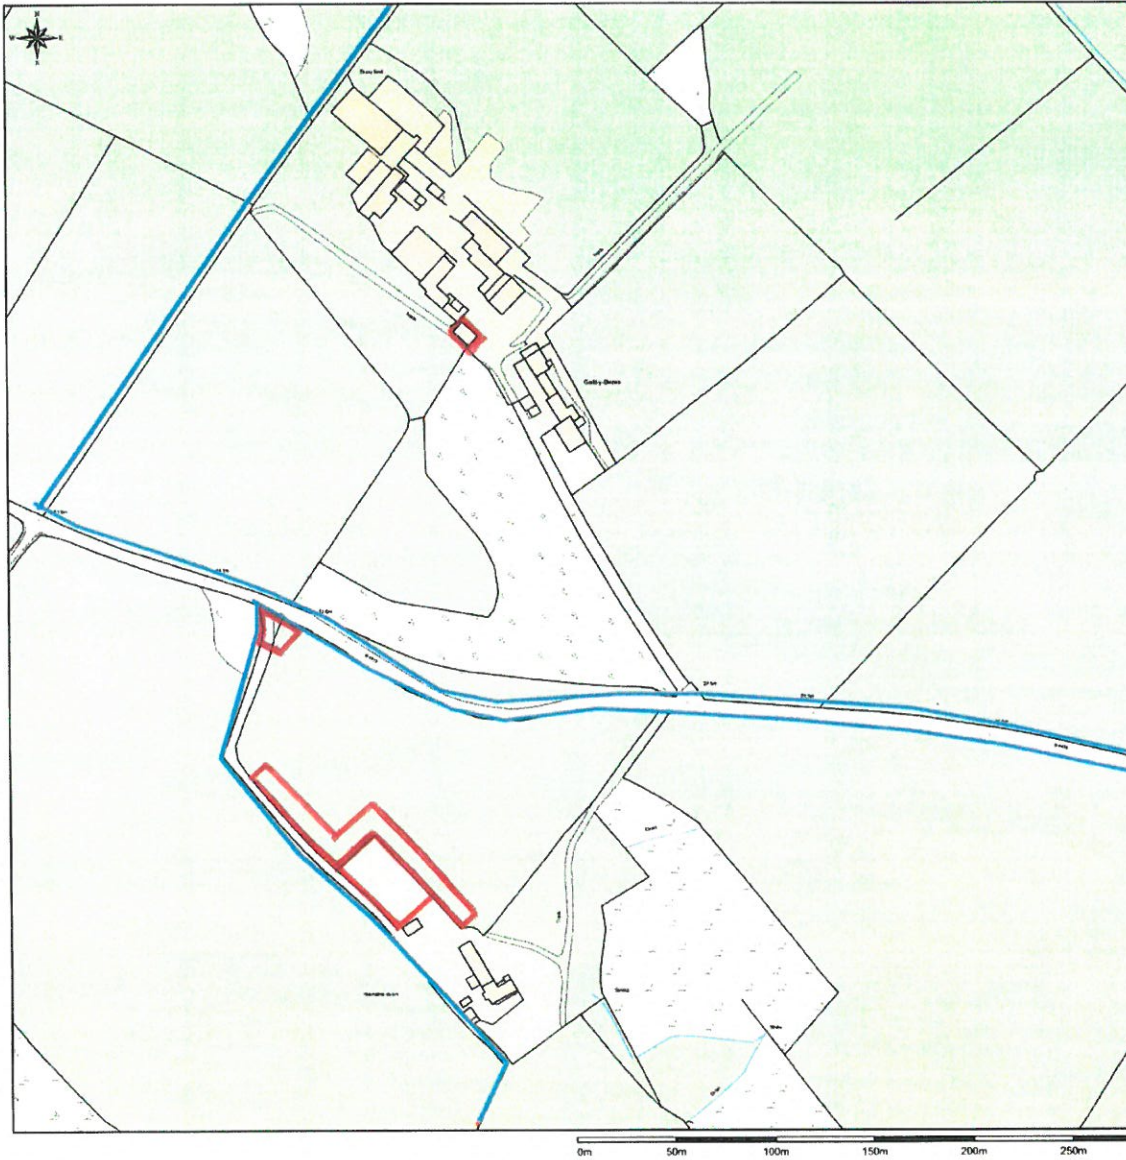


Scale: 1:2500, paper size: A3

This Plan includes the following Licensed Data: OS MasterMap Colour PDF Location Plan by the Ordnance Survey National Geographic Database and incorporating surveyed revision available at the date of production. Reproduction in whole or in part is prohibited without the prior permission of Ordnance Survey. The representation of a road, track or path is no evidence of a right of way. The representation of features, as lines is no evidence of a property boundary. © Crown copyright and database rights. 2015. Ordnance Survey 0100031673


plans ahead by emapsite™

Prepared by: Dylan Evans, 26-02-2015


EXISTING SOUTHWESTERN ELEVATION

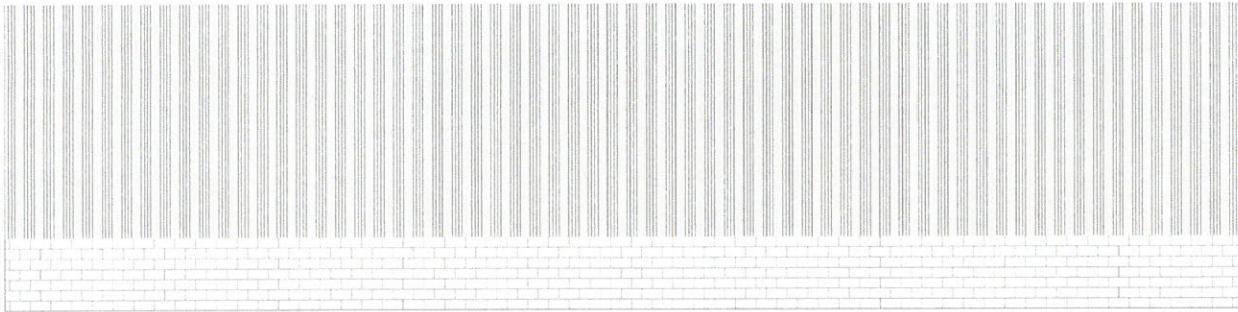


EXISTING SOUTHEASTERN ELEVATION

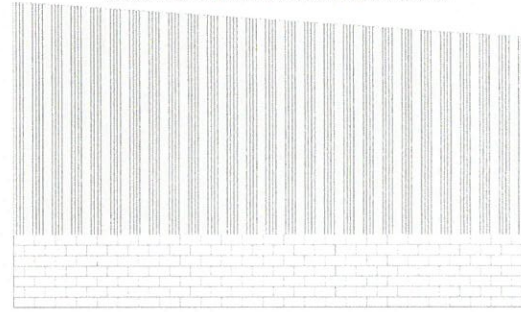


EXISTING NORTHWESTERN ELEVATION

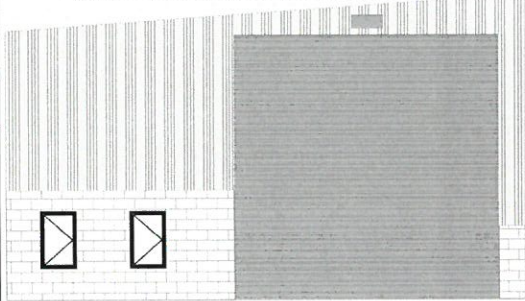


EXISTING NORTHEASTERN ELEVATION

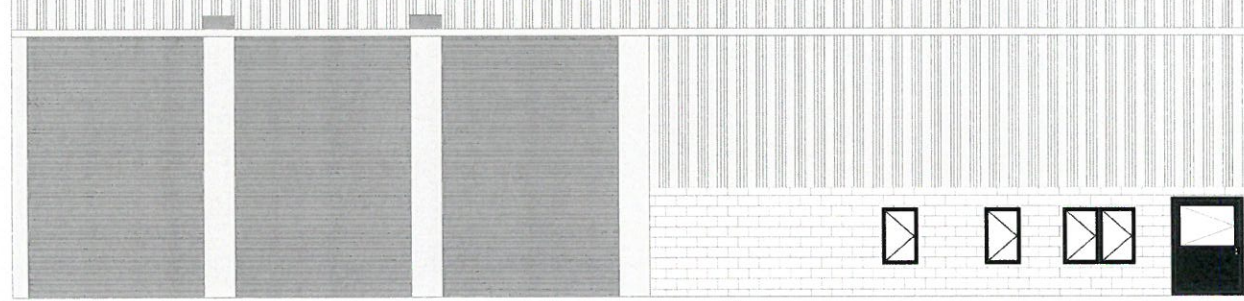


PROPOSED SOUTHWESTERN ELEVATION

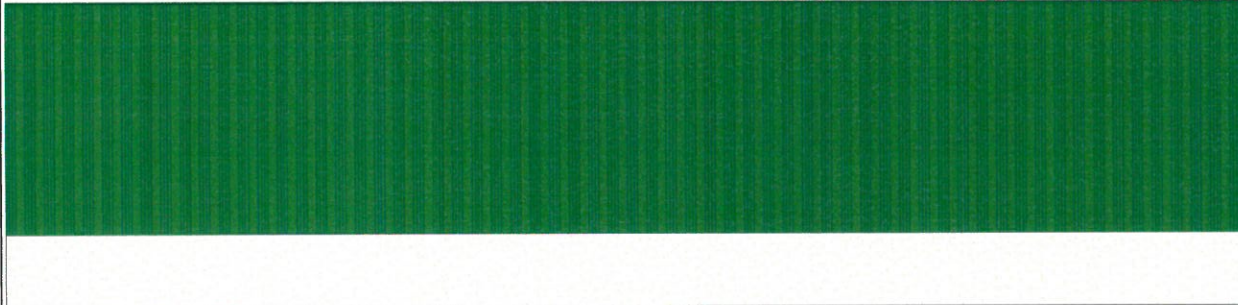


PROPOSED SOUTHEASTERN ELEVATION

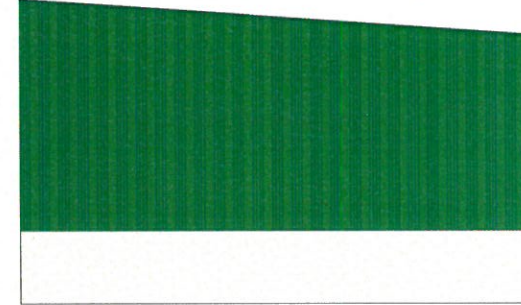

PROPOSED NORTHWESTERN ELEVATION

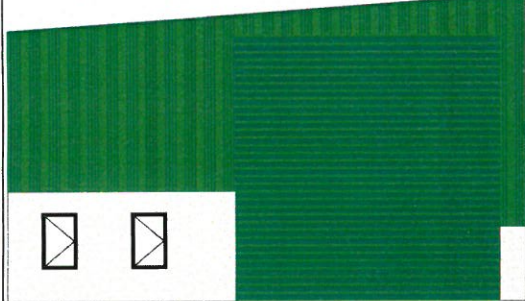

PROPOSED NORTHEASTERN ELEVATION

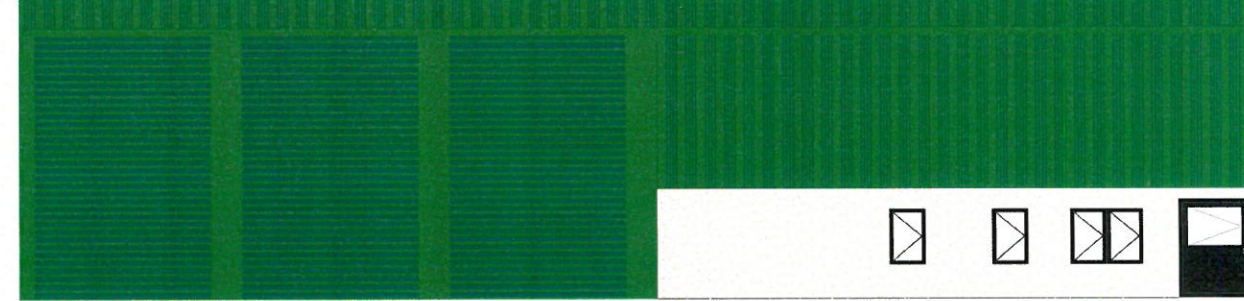

CLIENT/CIENT :

NODIADAU/NOTES

1. All dimensions in millimetres unless otherwise stated.
2. All levels in metres above Ordnance Datum.
3. All chainages in metres.

COMMENTS:

- a. All external flood lights to be removed
- b. External cladding to be coloured in Juniper Green

REF NO.	REVISIONS	DATE	BY




CYLLUN/SCHEME :
**MOT TESTING FACILITY AT
 HENDRE WEN
 RHYD Y CLAFDY**

TITL LUNAD/DRAWING TITLE :
EXISTING AND PROPOSED ELEVATIONS

DATE/UNWYD CAN : DRAWN BY : CHECKED BY : Sheet	DRP ABP 1 of 1	DATE/UNWYD CAN : DATE CHECKED : SCALE : 1/1/2013 1/1/2013 1:50 @ A1
---	----------------------	--

Rhif Lluniad
 Drawing No. **ABP/MI/107**

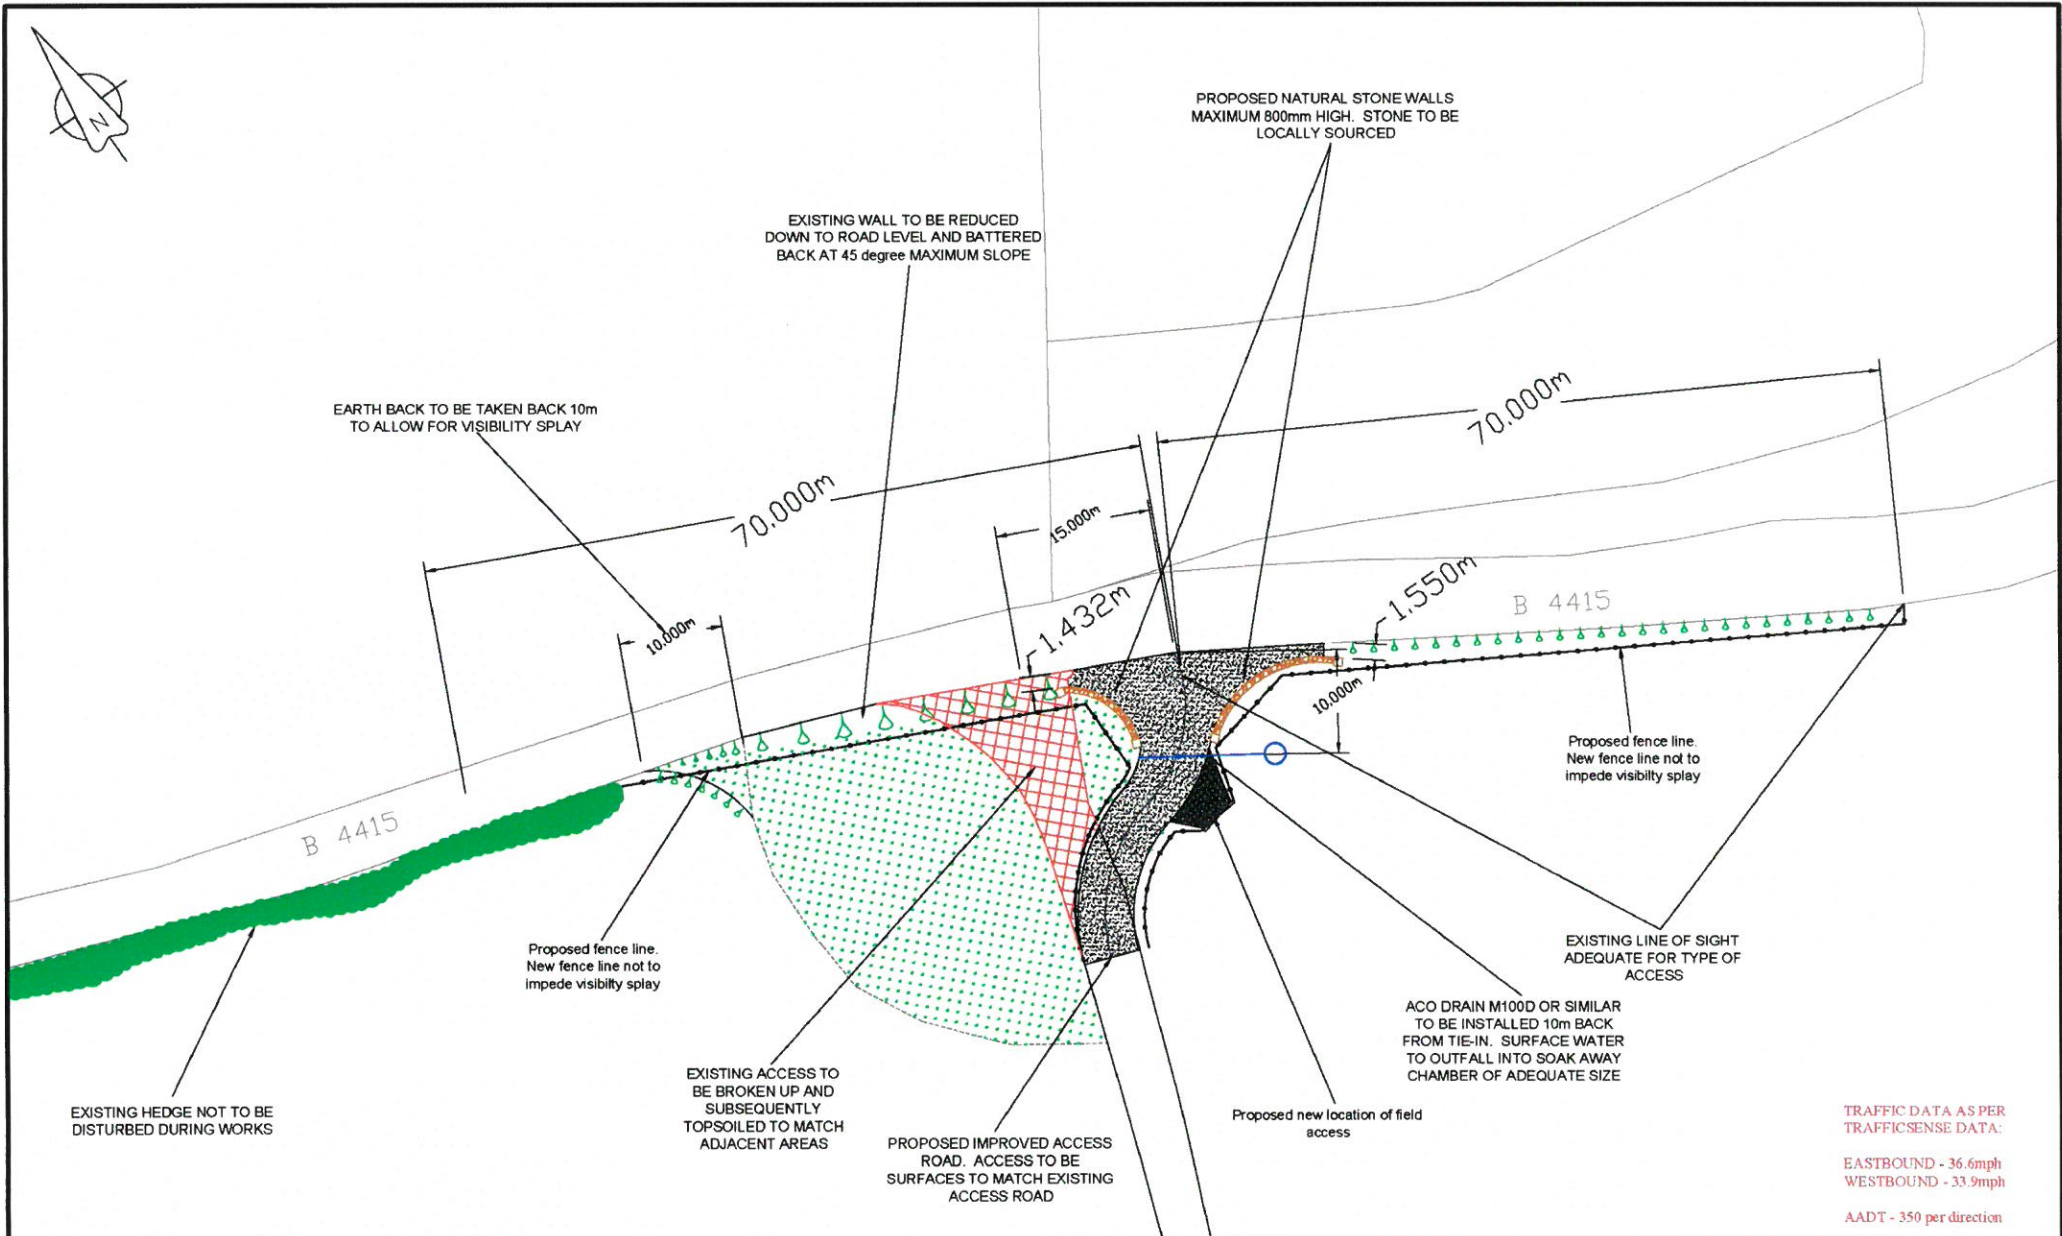


TRAFFIC DATA AS PER TRAFFICSENSE DATA:
 EASTBOUND - 36.6mph
 WESTBOUND - 33.9mph
 AADT - 350 per direction

Tel: 01756 740407
 Moduran Arwel Parry Motors
 Diagnostic, Air conditioning, Servicing

CYNLLUN/SCHEME :
MOT testing facility at Hendre Wen, Rhyd Y Clafdy

TEITL LLUNIAD/DRAWING TITLE :
Proposed access improvement

DARLUNWYD GAN : DRAWN BY :	DRP	DYDDIAD DARLUNWYD : DATE DRAWN :	12/07/2014
GWIRIWDYD GAN : CHECKED BY :	ABP	DYDDIAD GWIRIWDYD : DATE CHECKED :	12/07/2014
Tafien Sheet	1 of 1	GRADDFEYDD : SCALES :	1:500 @ A3
Rhif Lluniad Drawing No.	ABP/Access/2		CYWI REV D

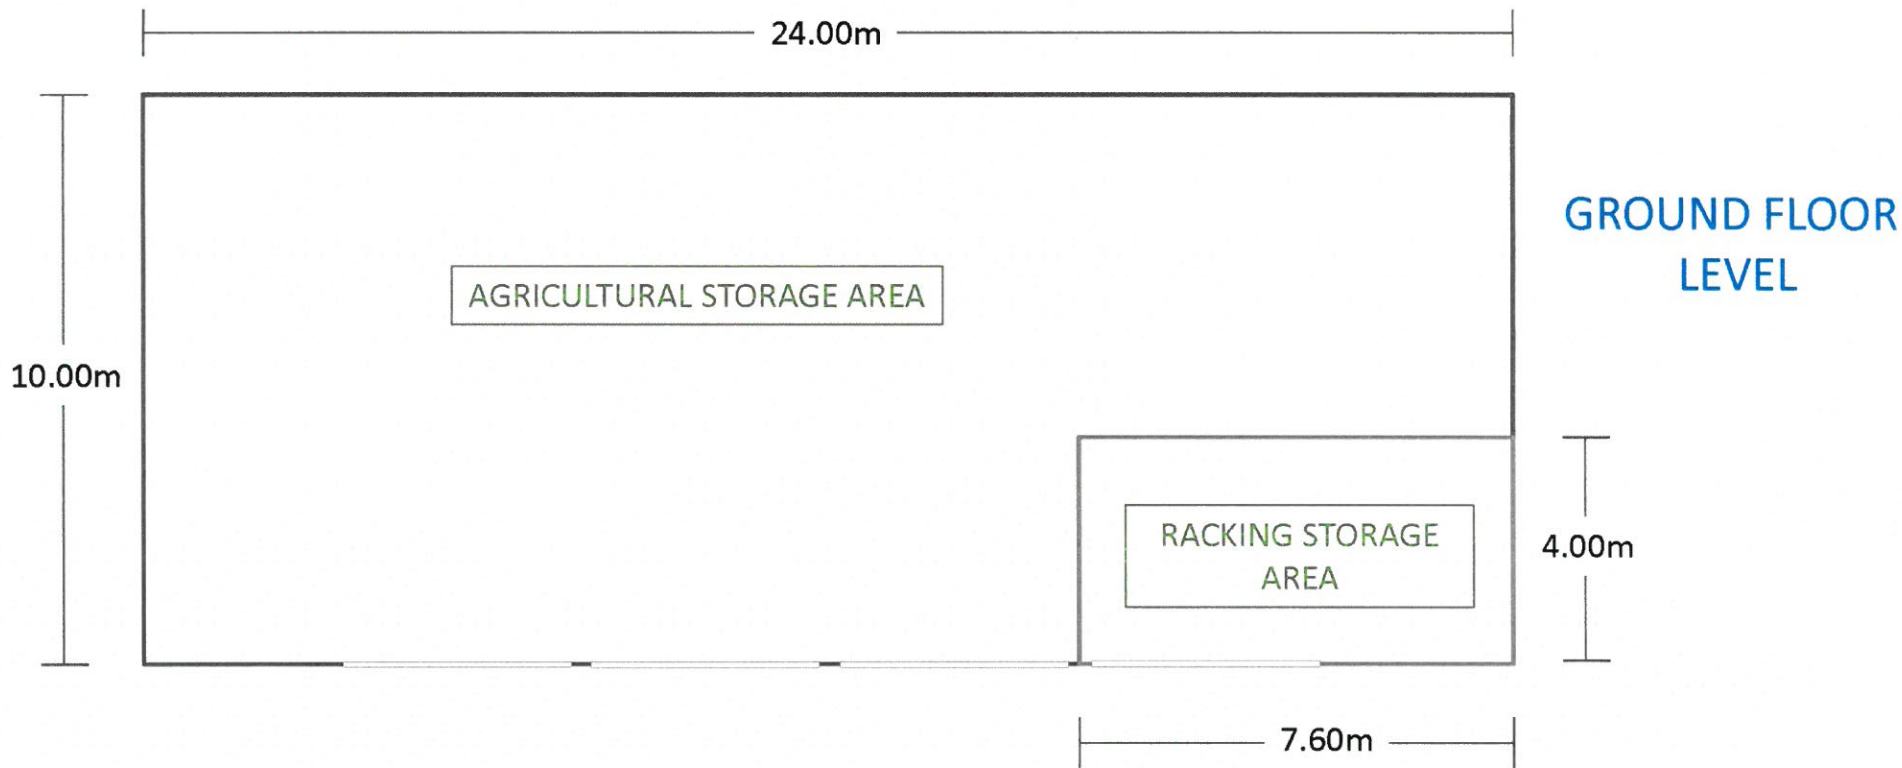


PERMITTED FLOOR PLAN

AGRICULTURAL STORAGE PORTAL
FRAME BUILDING
(AS APPROVED IN APPLICATION NO. 09D/0124/33/YA)

SCALE 1:100

RETROSPECTIVE CHANGE OF USE INCLUDING
PLANNED IMPROVEMENT WORKS AT
GALLT-Y-BEREN FARM, RHYDYCLAFDY

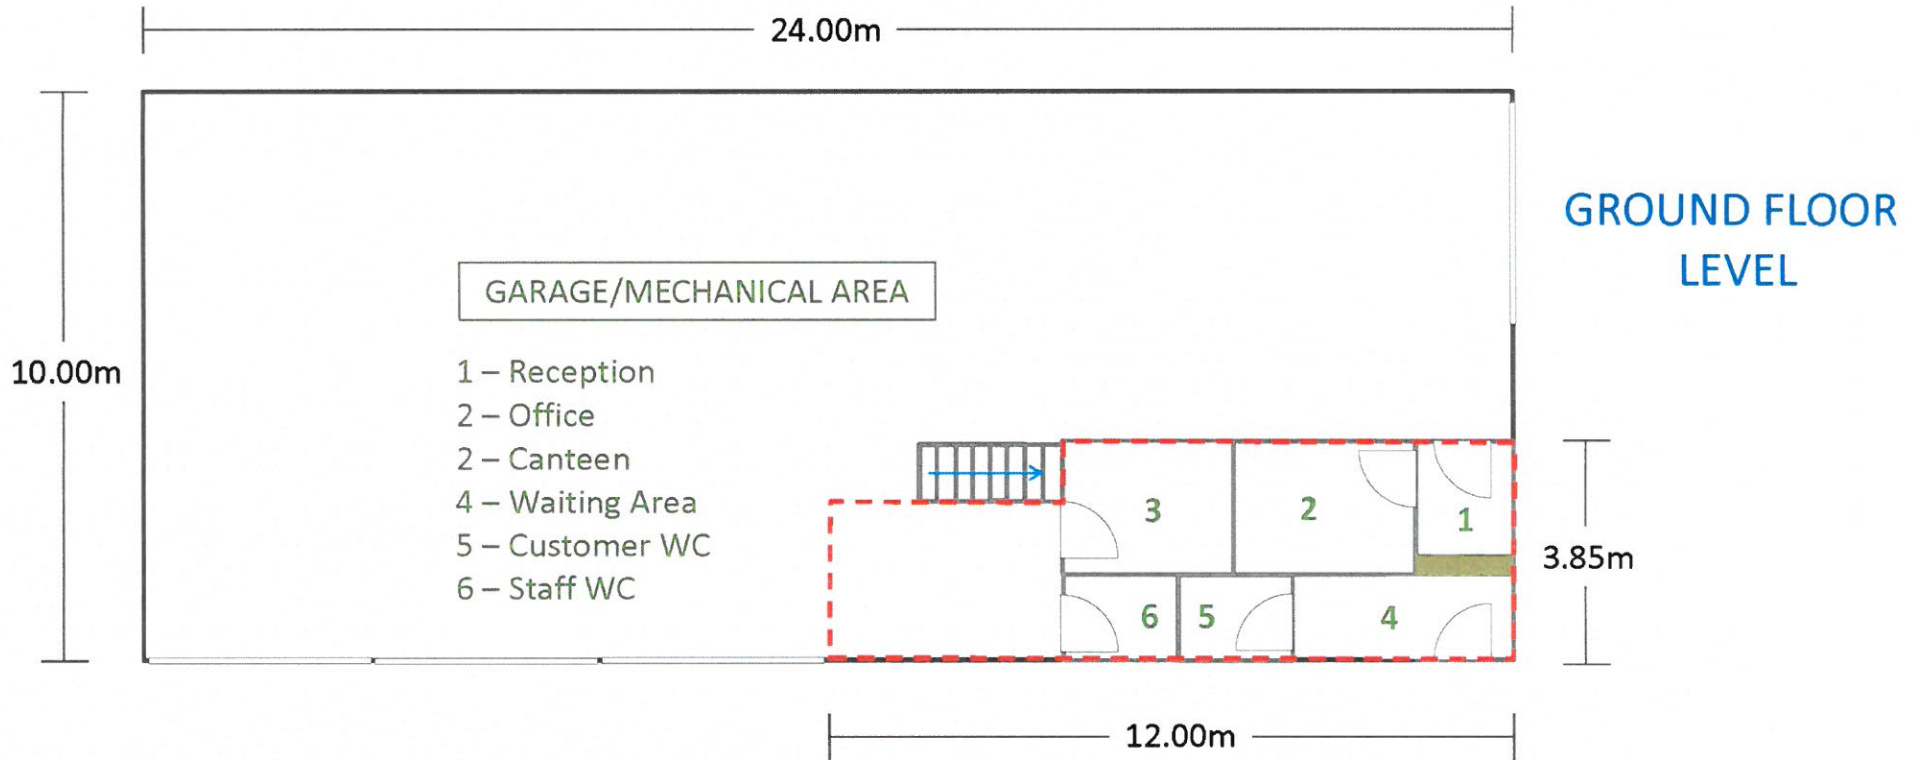

MEZZANINE STORAGE LEVEL

AS BUILT FLOOR PLAN

B2 VEHICLE REPAIR GARAGE PORTAL
 FRAME BUILDING

SCALE 1:100

RETROSPECTIVE CHANGE OF USE INCLUDING
 PLANNED IMPROVEMENT WORKS AT
 GALLT-Y-BEREN FARM, RHYDYCLAFDY